CITY OF HIGH POINT AGENDA ITEM



Title: Right-Of-Way Encroachment RE-19-0010 (Crown Mark)

From: Lee Burnette, Meeting Date: June 17, 2019

Planning & Development Director

Public Hearing: No Advertising Date: Not Applicable

Attachments: Staff Report **Advertised By:** Not Applicable

PURPOSE:

A request by Huntington Furniture Industries Inc for a 2.47-square foot encroachment to install a portion of a railing and stair within the E. Green Drive right-of-way.

BACKGROUND:

Staff report and recommendation is enclosed.

BUDGET IMPACT:

There is no budget impact.

RECOMMENDATION / ACTION REQUESTED:

Staff recommends *approval* of Right-Of-Way Encroachment RE-19-0010.

CITY OF HIGH POINT PLANNING AND DEVELOPMENT DEPARTMENT

RIGHT-OF-WAY ENCROACHMENT RE-19-0010 June 17, 2019

Request			
Applicant:	Proposal:		
Huntington Furniture	To allow a 2.47-square foot encroachment to install a portion		
Industries Inc.	of a railing and stair within the E. Green Drive right-of-way.		

Adjacent Streets			
Name:	Classification:	R/W Width:	
S Wrenn Street	Collector	60 feet	
E Green Drive	Collector	60 feet	

Analysis

The applicant is requesting permission to allow a portion of a railing and stair to encroach 1.6 linear feet into the E. Green Drive right of way for an approximate 2.47-square foot encroachment.

The Technical Review Committee reviewed the request and found that the proposed location of the railing and stair would not affect public safety or interfere with street or utility maintenance.


The railing and stair renderings are attached, as well as a site plan depicting the location of the proposed encroachment.

Recommendation

Staff recommends approval of Right-Of-Way Encroachment RE-19-0010 contingent upon the applicant installing the improvements as depicted on the attached drawing.

Report Preparation

This report was prepared by Planning and Development Department staff member Samuel G. Hinnant, CZO, CFM and was reviewed by Robert L. Robbins, AICP and G. Lee Burnette, AICP.

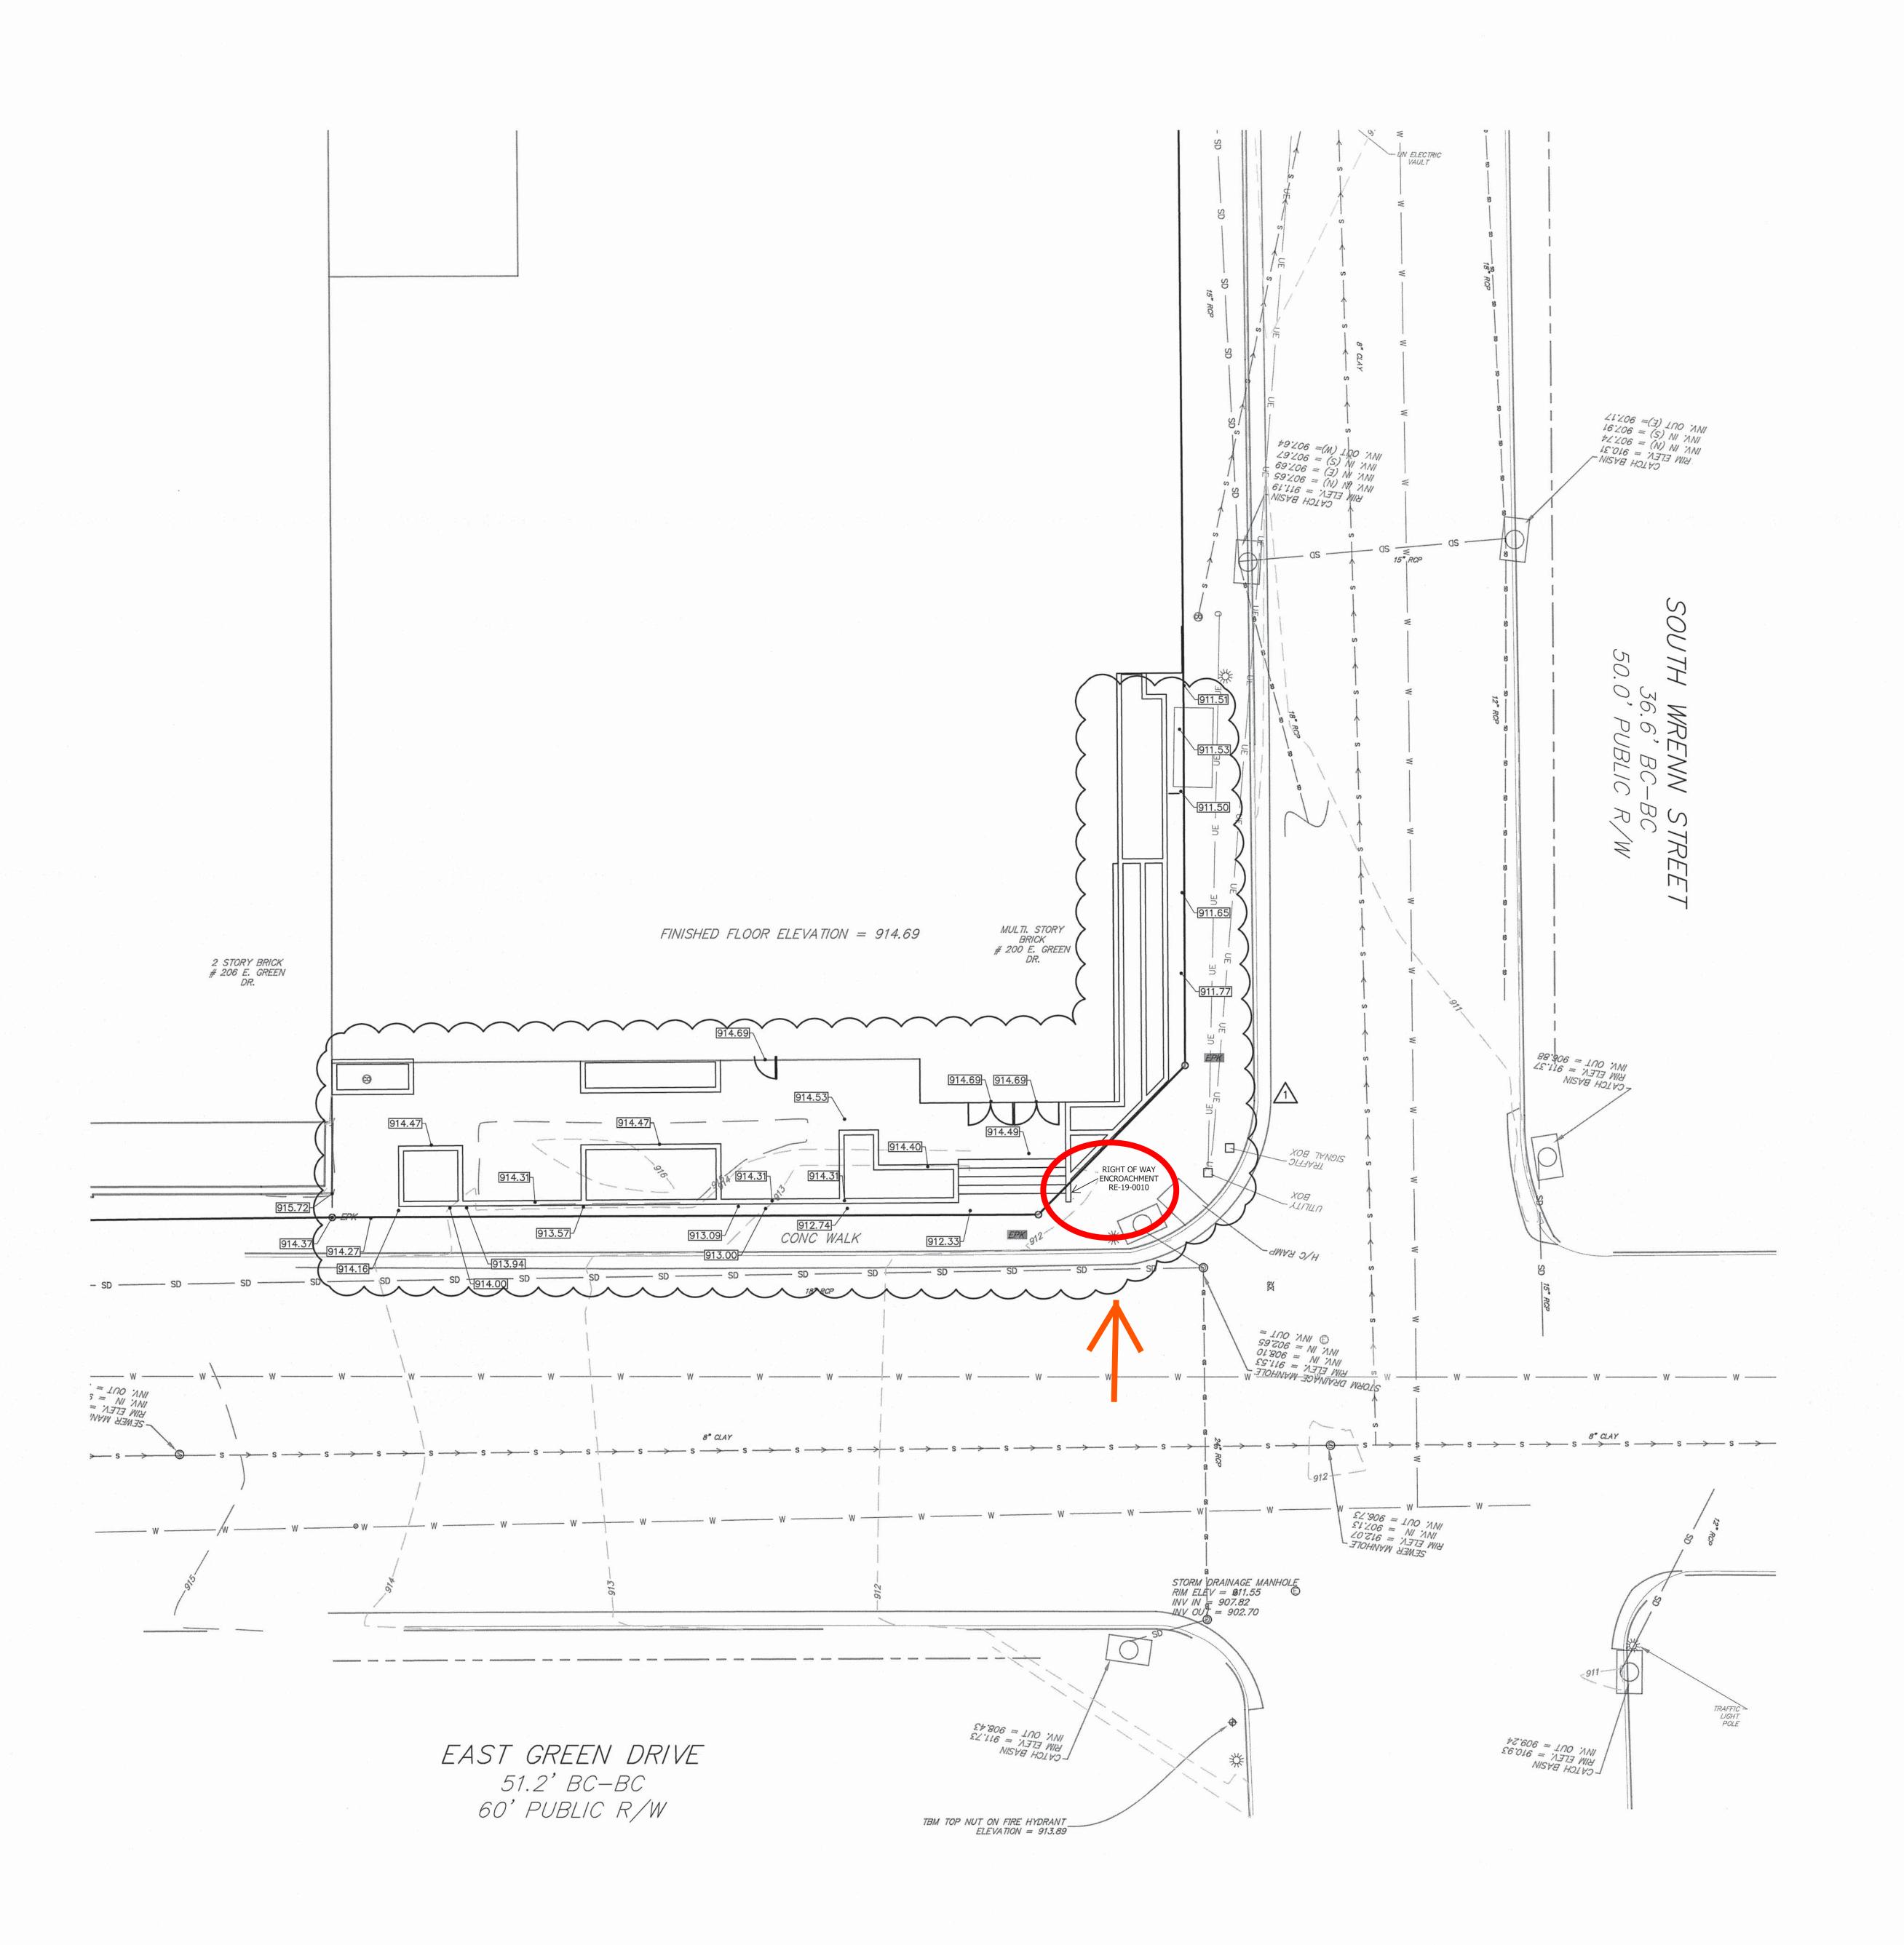




4810 WEST UNIVERSITY AVE. LAS VEGAS, NV 89103 TEL: 702.220.3900 FAX: 702.220.3503 WWW.DWALTONARCH.COM





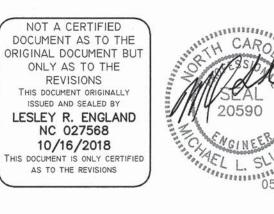

CROWN MARK FURNITURE

CROWN MARK EXTERIOR RENOVATION

HIGH POINT, NC

DATE

PROJECT NO.: 170805

DRAWN: DMP

CHECKED BY: RWK

DATE: 10/1

REVISION


5/10/19 CITY OF HIGH POINT REVIEW COMMENTS

100% CONSTRUCTION DOCUMENT

REPRODUCTION OF THIS DRAWING IS EXPRESSLY FORBIDDEN WITHOUT THE SPECIFIC WRITTEN PERMISSION OF DWA PLLC. THIS DRAWING IS ONLY CONDITIONALLY ISSUED, AND METIRE RECEIPT OR POSSESSION THEREOF CONFERS OR TRANSFERS ANY RIGHT TO, OR LICENSE TO, USE THE SUBJECT MATER OF THIS DRAWING OR ANY TECHNICAL INFORMATION SHOWN THEREON, NOR ANY RIGHT TO REPRODUCE THIS DRAWING OR PART THEREOF, WITHOUT THE WRITTEN AUTHORIZATION OF DWA PLLC.

GRADING PLAN

C1.3

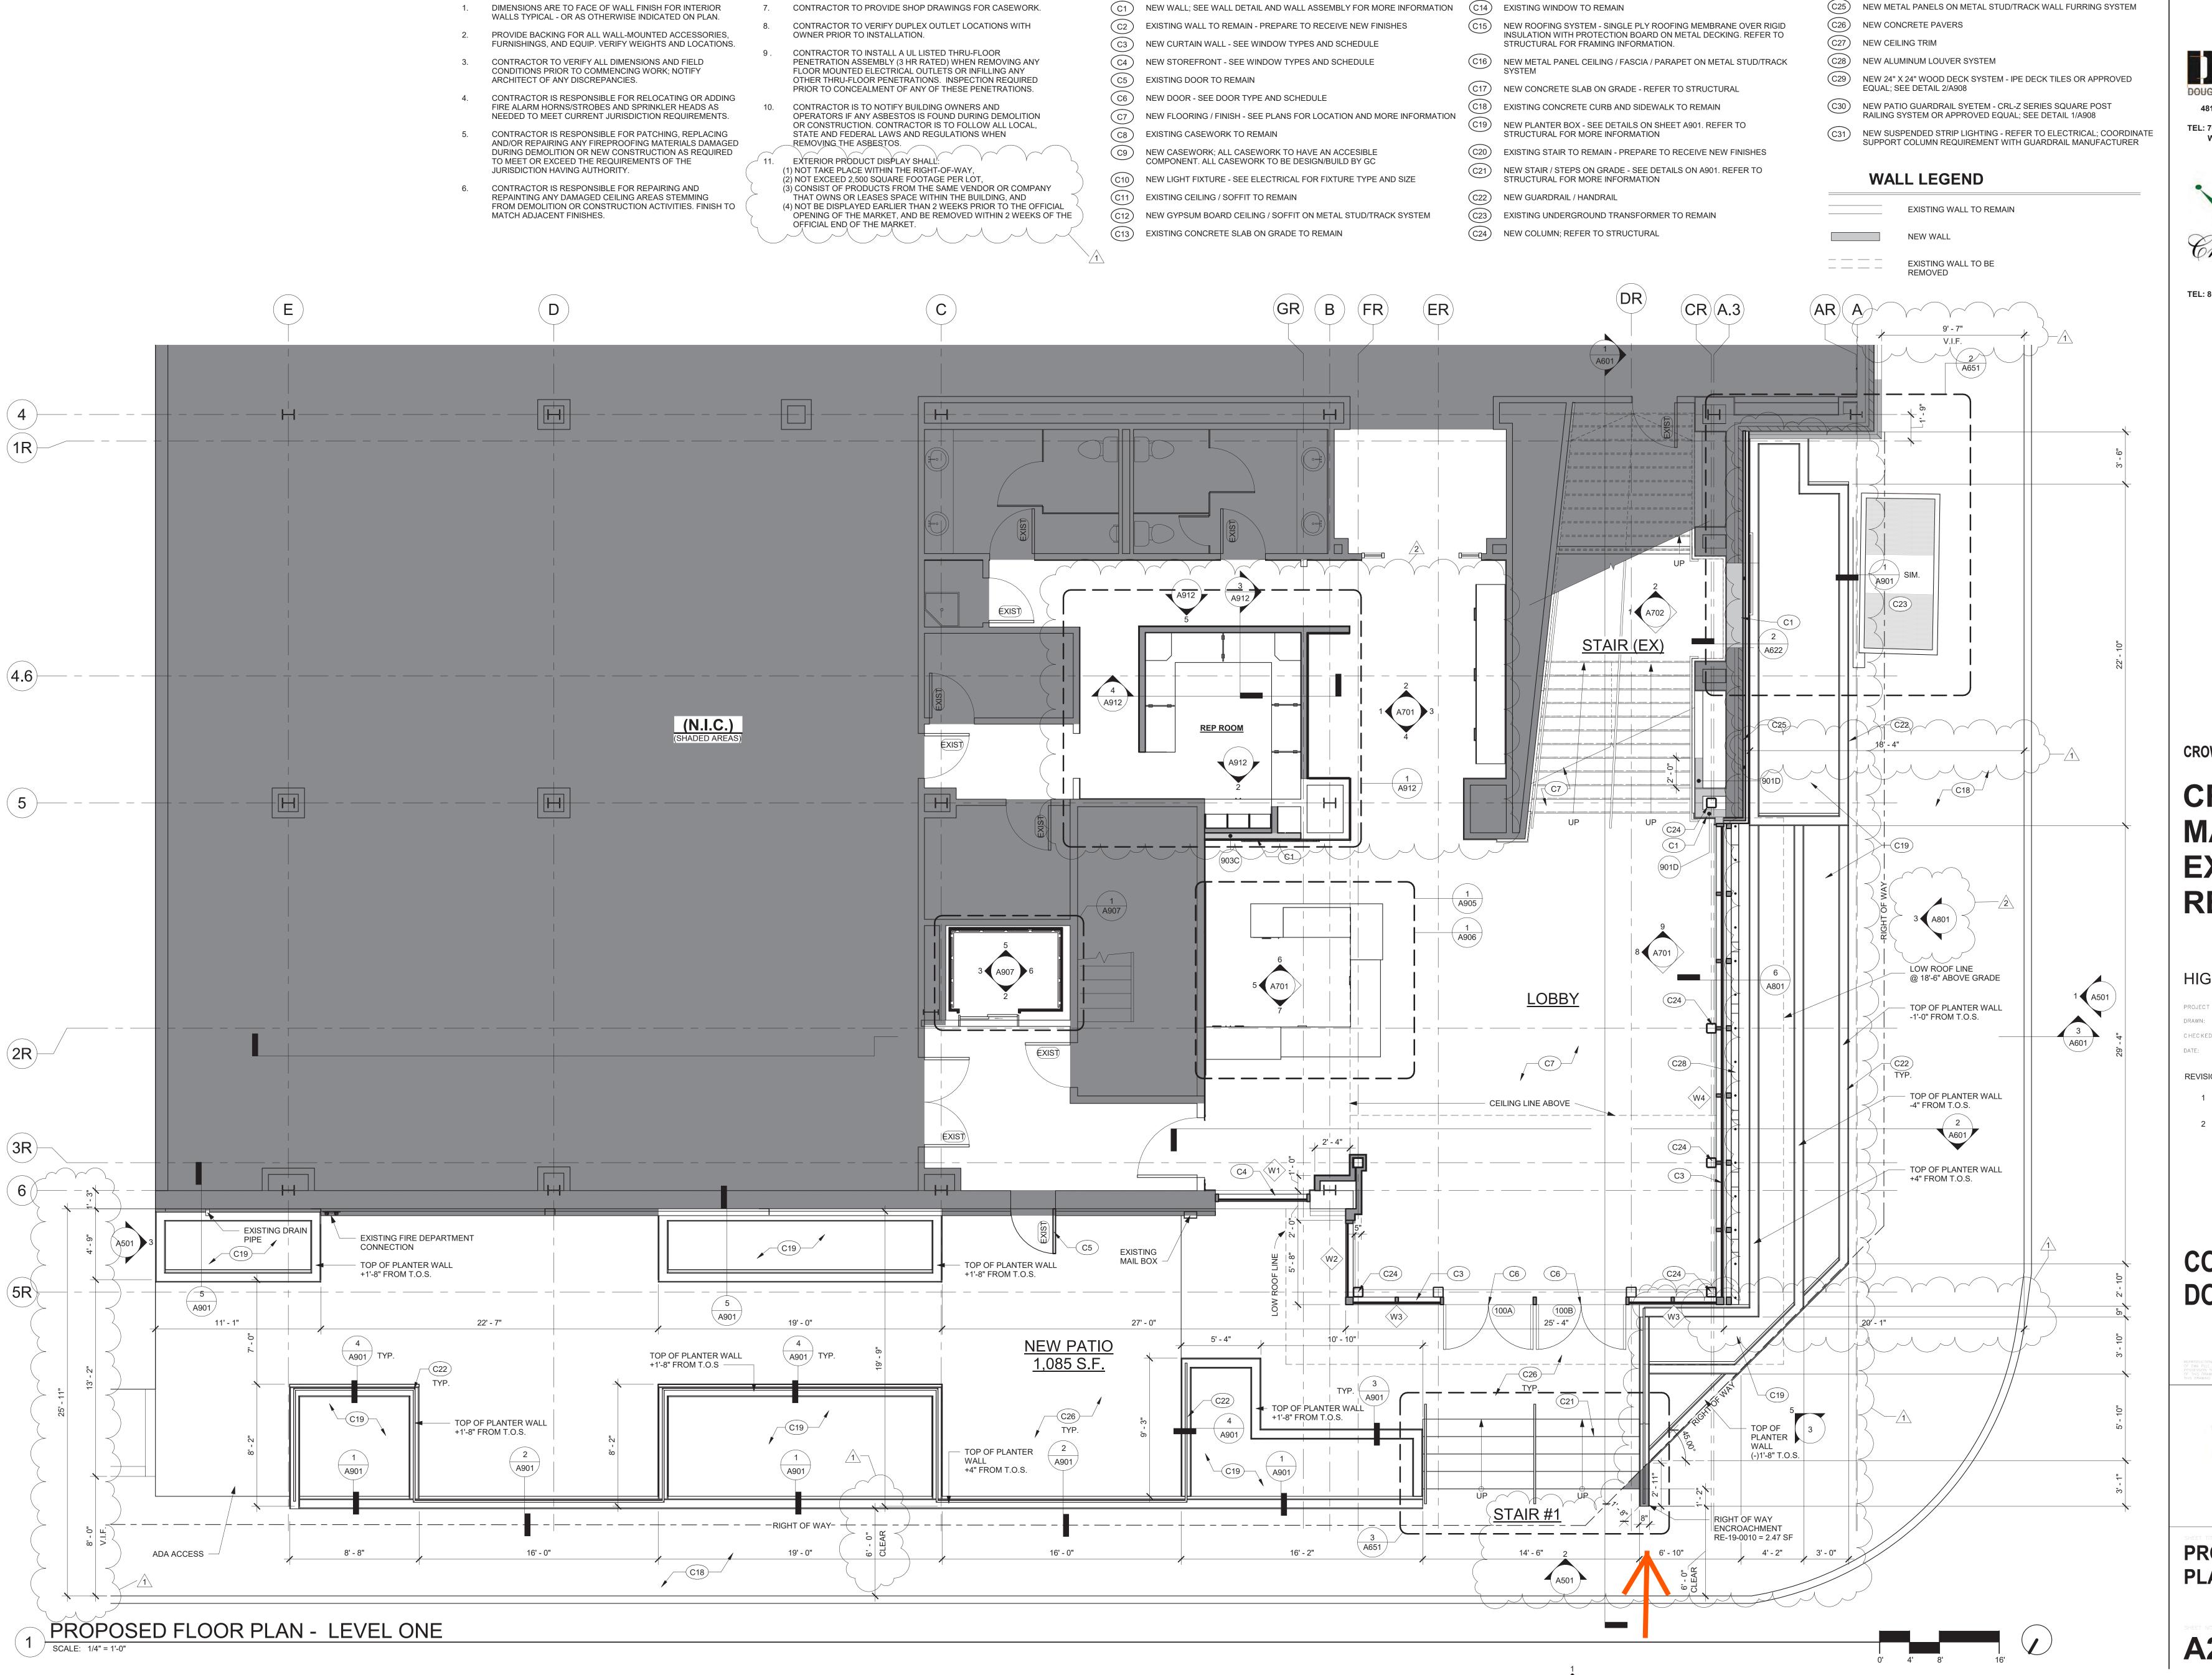

PLAN KEY NOTES

GENERAL NOTES



DOUG WALTON / ARCHITECT PLLC

4810 WEST UNIVERSITY AVE.
LAS VEGAS, NV 89103

TEL: 702.220.3900 FAX: 702.220.3503
WWW.DWALTONARCH.COM



200 EAST GREEN DRIVE
HIGH POINT, NC 27260
TEL: 800.249.2769 FAX: 832.295.9501
Cmi@Crownmark.com

CROWN MARK FURNITURE

CROWN MARK EXTERIOR RENOVATION

HIGH POINT, NC

T NO.: 170805.5 MM, EC

DATE DES

DATE DESCR

COMMENTS

5-10-19 OWNER REVISION

CONSTRUCTION DOCUMENTS

REPRODUCTION OF THIS DRAWING IS EXPRESSLY FORBIDDEN WITHOUT THE SPECIFIC WRITTEN PERMIT OF DWA PILC. THIS DRAWING IS ONLY CONDITIONALLY ISSUED, AND NETHER RECEIPT OR POSSESSION THEREOF CONFESS OR TRANSFERS ANY RICHT TO, OF LICENSE TO, USE THE SUBJECT OF THIS DRAWING OR ANY TECHNICAL INFORMATION SHOWN THEREON, NOR ANY RIGHT TO REPRODUCTIVES DRAWING OR PART THEREOF, WITHOUT THE WRITTEN AUTHORIZATION OF DWA PILC.




PROPOSED FLOOR PLAN - LEVEL ONE

A211



6 PATIO VIEW AT ENTRY
SCALE: N.T.S.

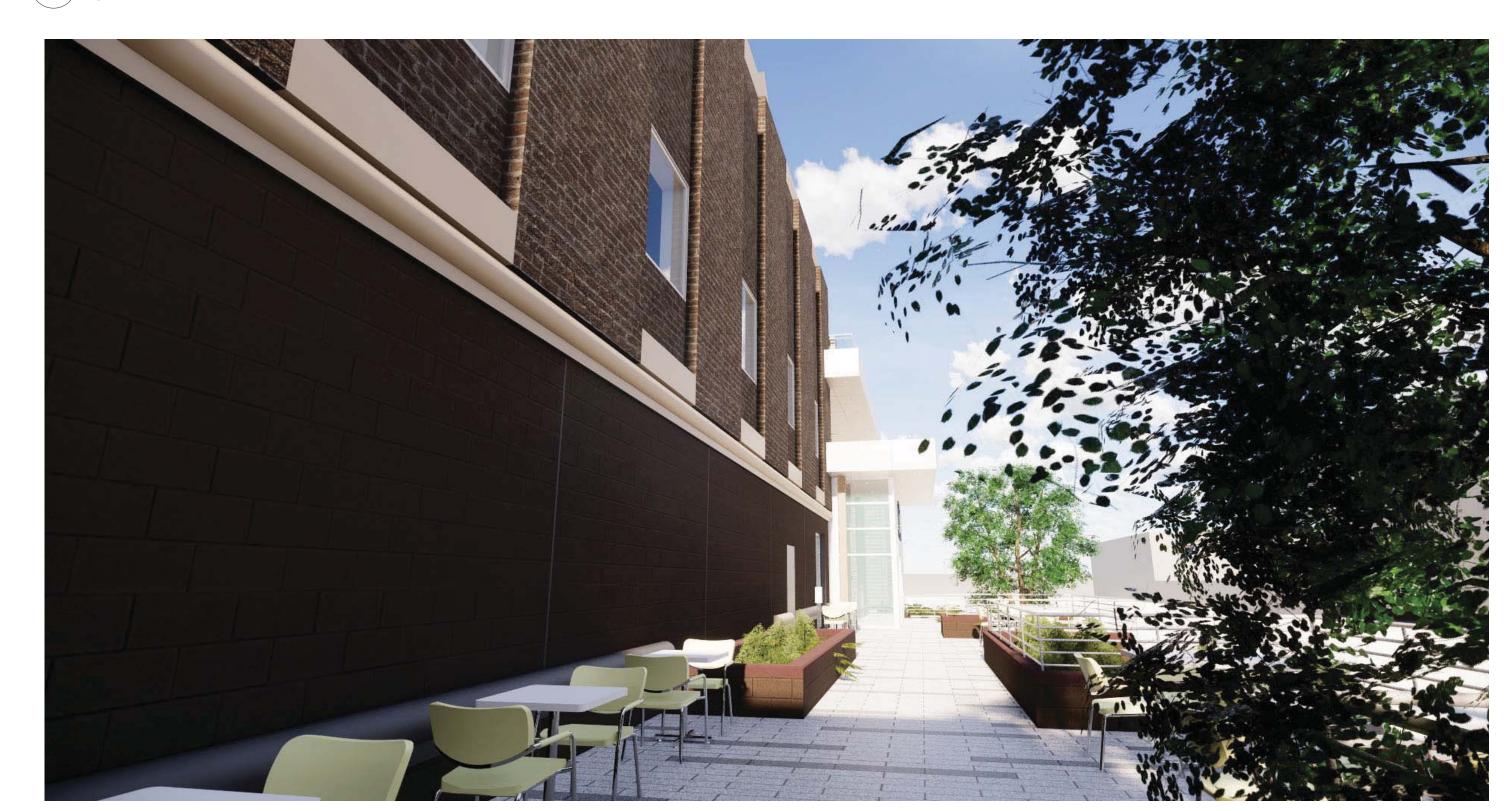

PATIO VIEW APPROACHING FROM THE WEST

SCALE: N.T.S.



2 VIEW FROM NORTHWEST SCALE: N.T.S.



5 PATIO VIEW AT ENTRY
SCALE: N.T.S.



3 VIEW FROM SOUTHEAST SCALE: N.T.S.








CROWN MARK FURNITURE

CROWN MARK EXTERIOR RENOVATION

HIGH POINT, NC

,	
170805.5	
MM, EC	
RWK	
03/01/19	
DATE	DESCRIPTION
5-1-19	CITY OF HP COMMENTS
	170805.5 MM, EC RWK 03/01/19 DATE

CONSTRUCTION DOCUMENTS

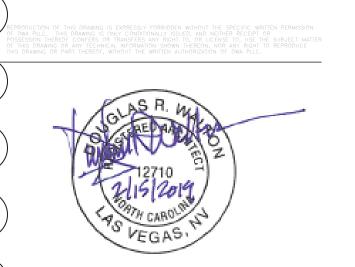

RENDERINGS

A010